


LEGEND

- - Flow arrow.
- - - - - Building setback envelope.
- Allowable driveway access.
- - - - - RP boundary.
- Sewer main.
- - Sewer manhole.
- uPVC water main.
- Poly water main.
- Stormwater drain line.
- Sewer main.
- - Sewer manhole.
- Water main.
- Poly water main.
- For sewer zone of influence, refer to Townsville City Council sewer policy.

- NOTES:**
- BUILDING SETBACK**
- Dimensions shown apply to single storey Class 1 buildings. For 2 storey Class 1 buildings, setbacks shall conform to the requirements of the Queensland Development Code. For Class 10a and 10b buildings, setbacks shall conform to the requirements of the Queensland Development Code.
 - All setback distances are taken from the outermost projection which is a distance measured from the edge of the fascia board to the property boundary.
 - All setbacks shown are minimum distances and may vary to accommodate the zone of influence of underground services as stated in Council's policy on Building Over or Adjacent to Sewers.
 - All allotment areas are indicative only. Refer to Plan of Survey for true allotment areas.

- DRIVEWAY ACCESS ENVELOPE**
- For driveway access envelope allow 0.5m minimum clearance to all Council infrastructure, except stormwater manholes which require 0.6m minimum clearance or beyond the kerb inlet transition, and sewerage house connections which require 1.2m clearance.
 - All driveways require a permit to carry out works on Council controlled land prior to construction.
 - For clearances to Telstra and Ergon Energy infrastructure, refer to the relevant authority.

- CLIMATICALLY RESPONSIVE BUILDING DESIGN**
- The following design parameters could be considered during the design phase of proposed dwellings.
 - (i) A building orientation that minimises the length of external wall areas that are exposed to solar radiation;
 - (ii) An internal layout ensuring that living areas are protected from summer solar radiation (i.e. living areas orientated north to north-east and service areas are orientated to the west and south);
 - (iii) Building projections are used to minimise summer solar radiation to external walls (i.e. carports, large overhangs, external screens) are incorporated that fully shade western and south-west facing external walls from solar radiation; and
 - (iv) A building layout that maximises the capture of prevailing breezes (living area windows and doors are orientated to the north-east), room layouts and internal access ways are designed to maximise cross ventilation).

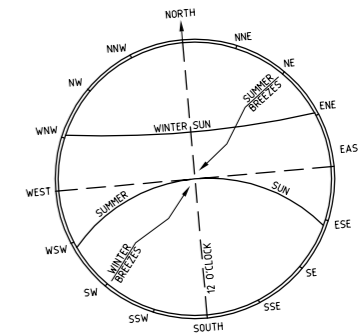

AS CONSTRUCTED
 I, Andrew Ian Wallace of Northern Consulting Engineers hereby certify that the works as shown on the as constructed drawings reflect any changes that were made during the course of construction.

Andrew Ian Wallace
 Andrew Ian Wallace - (RPEQ No. 6743) Date: 20/09/17

All work is carried out in accordance with LOCAL AUTHORITIES standard details.

REAL PROPERTY DESCRIPTION
 Lot 900 on SP289582
 Parish of BOHLE
 County of ELPHINSTONE
 Conway Street - Mount Low


LEVEL DATUM A.H.D. (Der)
 Horizontal Datum GDA' 94 Zone 55
 Refer PM 193518 RL. 8.195
 Bolt and washer in kerb
 FREMONT STREET.

Scale 0 2.5 5 7.5 10m
 THE ORIGINAL OF THIS DOCUMENT IS COMPLETED TO THE SCALE NOTED. AS REPRODUCTION CAN DISTORT SIZE & SHAPE USE ONLY THE DIMENSIONS PROVIDED ON ARCHITECTURAL &/OR ENGINEERING DRAWINGS. VERIFY DIMENSIONS ON SITE BEFORE CONSTRUCTION.



Civil & Structural Engineers
 50 Punari Street, Currajong 4812
 Phone: [07] 4725 5550 Fax: [07] 4725 5850
 Email: mail@nceng.com.au
 Milton Messer & Associates Pty. Ltd.
 ACN 100 817 356

A ISSUED FOR AS CONSTRUCTED.		20/09/2017
Issue	Description	Date
Drawn KJM Date 20/09/2017 Checked D.A. Approved MS COPYRIGHT ©	In Association With BUSHLAND GROVE PTY LTD BUSHLAND GROVE ESTATE STAGE 13, 26 ALLOTMENT RESIDENTIAL SUBDIVISION, MOUNT LOW	BUILDING ENVELOPE & ACCESS PLAN
Drawing Number TUR0813/E1		Issue A

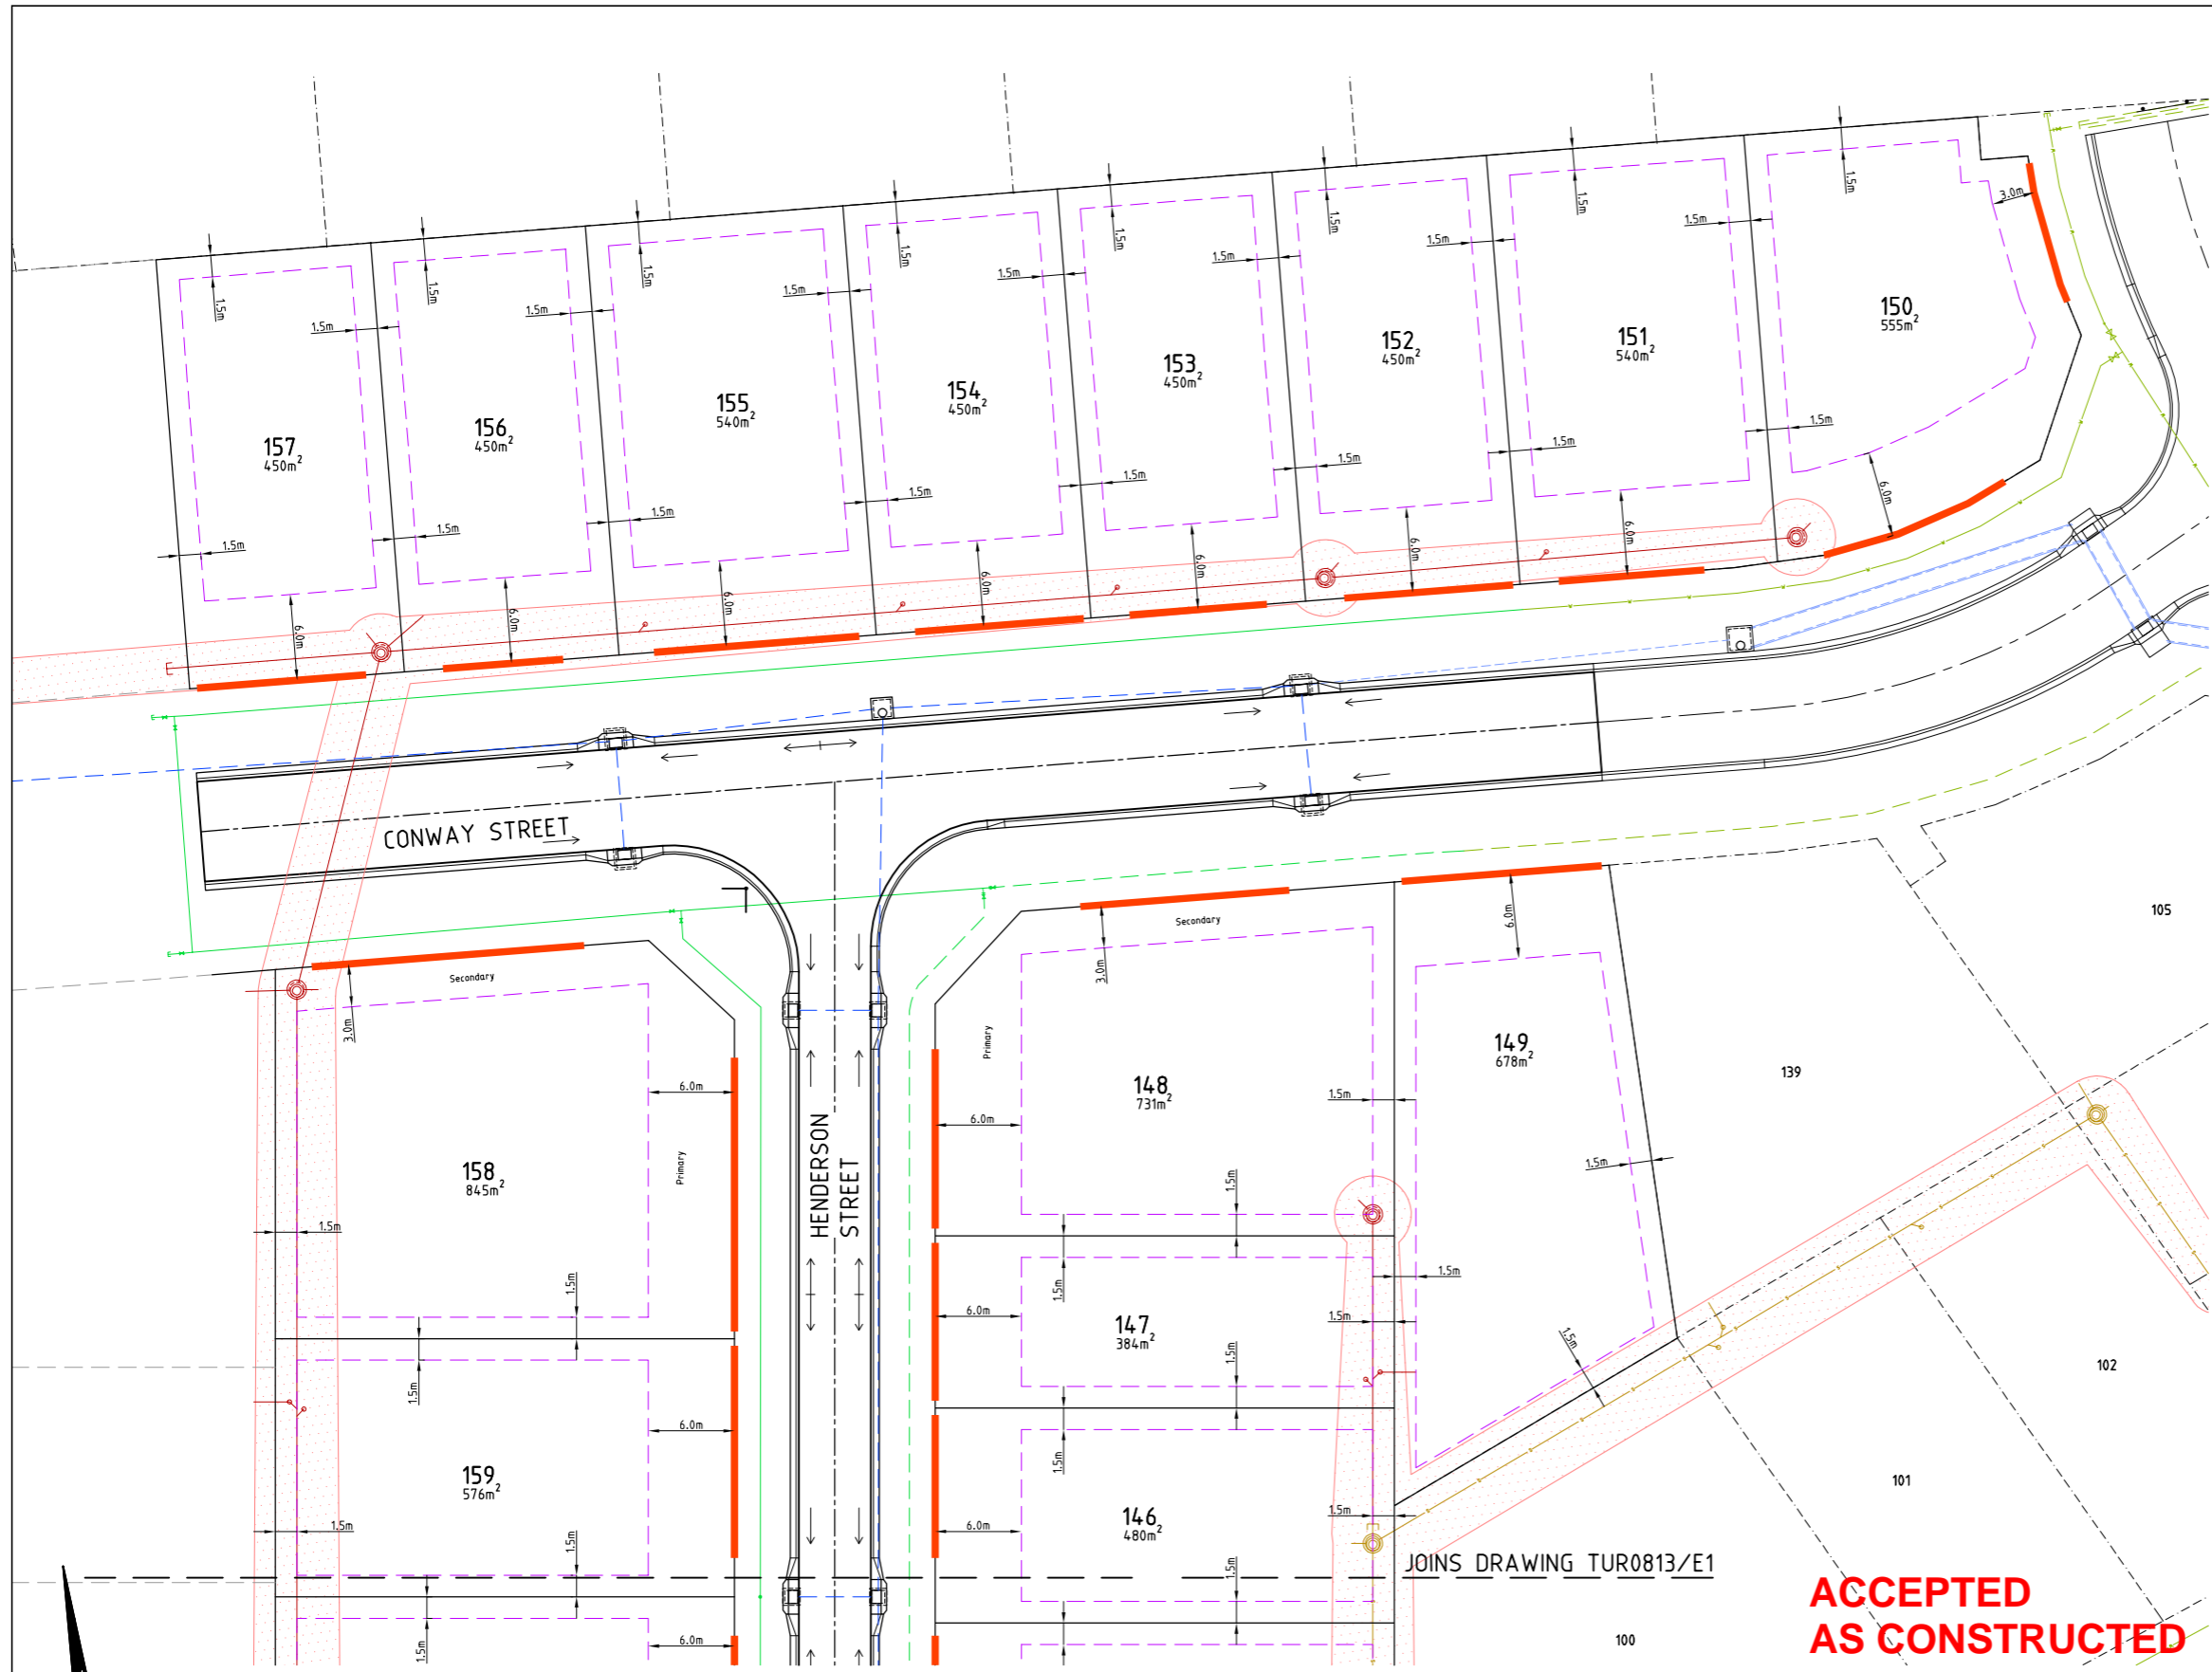


- LEGEND**
- - Flow arrow.
 - - - - - Building setback envelope.
 - Allowable driveway access.
 - - - - - RP boundary.
 - - - - - Sewer main.
 - Sewer manhole.
 - - - - - uPVC water main.
 - - - - - Poly water main.
 - - - - - Stormwater drain line.
 - - - - - Stormwater drain line.
 - - - - - Sewer main.
 - Sewer manhole.
 - - - - - Water main.
 - - - - - Poly water main.
 - - For sewer zone of influence, refer to Townsville City Council sewer policy.

- NOTES:**
- GENERAL**
- Nominated road frontage - lots 148 & 158 is Henderson Street.
- lots 150 is Conway Street.
- BUILDING SETBACK**
- Dimensions shown apply to single storey Class 1 buildings. For 2 storey Class 1 buildings, setbacks shall conform to the requirements of the Queensland Development Code. For Class 10a and 10b buildings, setbacks shall conform to the requirements of the Queensland Development Code.
 - All setback distances are taken from the outermost projection which is a distance measured from the edge of the fascia board to the property boundary.
 - All setbacks shown are minimum distances and may vary to accommodate the zone of influence of underground services as stated in Council's policy on Building Over or Adjacent to Sewers.
 - All allotment areas are indicative only. Refer to Plan of Survey for true allotment areas.

- DRIVEWAY ACCESS ENVELOPE**
- For driveway access envelope allow 0.5m minimum clearance to all Council infrastructure, except stormwater manholes which require 0.6m minimum clearance or beyond the kerb inlet transition, and sewerage house connections which require 1.2m clearance.
 - All driveways require a permit to carry out works on Council controlled land prior to construction.
 - For clearances to Telstra and Ergon Energy infrastructure, refer to the relevant authority.

- CLIMATICALLY RESPONSIVE BUILDING DESIGN**
- The following design parameters could be considered during the design phase of proposed dwellings.
 - A building orientation that minimises the length of external wall areas that are exposed to solar radiation;
 - An internal layout ensuring that living areas are protected from summer solar radiation (i.e. living areas orientated north to north-east and service areas are orientated to the west and south);
 - Building projections are used to minimise summer solar radiation to external walls (i.e. carports, large overhangs, external screens) are incorporated that fully shade western and south-west facing external walls from solar radiation; and
 - A building layout that maximises the capture of prevailing breezes (living area windows and doors are orientated to the north-east), room layouts and internal access ways are designed to maximise cross ventilation).

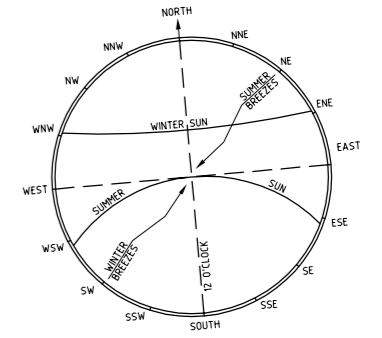

AS CONSTRUCTED
 I, Andrew Ian Wallace of Northern Consulting Engineers hereby certify that the works as shown on the as constructed drawings reflect any changes that were made during the course of construction.
 Andrew Ian Wallace - (RPEQ No. 6743) Date: 20/09/17


LAYOUT PLAN

All work is carried out in accordance with LOCAL AUTHORITIES standard details.

REAL PROPERTY DESCRIPTION
 Lot 900 on SP289582
 Parish of BOHLE
 County of ELPHINSTONE
 Conway Street - Mount Low

* - Indicates as constructed information.

LEVEL DATUM A.H.D. (Der)
 Horizontal Datum GDA' 94 Zone 55
 Refer PM 193518 RL. 8.195
 Bolt and washer in kerb
 FREMONT STREET.

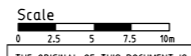

THE ORIGINAL OF THIS DOCUMENT IS COMPLETED TO THE SCALE NOTED. AS REPRODUCTION CAN DISTORT SIZE & SHAPE USE ONLY THE DIMENSIONS PROVIDED ON ARCHITECTURAL &/OR ENGINEERING DRAWINGS. VERIFY DIMENSIONS ON SITE BEFORE CONSTRUCTION.



Civil & Structural Engineers
 50 Punari Street, Currajong 4812
 Phone: [07] 4725 5550 Fax: [07] 4725 5850
 Email: mail@nceng.com.au
 Milton Messer & Associates Pty. Ltd.
 ACN 100 817 356

A ISSUED FOR AS CONSTRUCTED.		20/09/2017
Issue	Description	Date
Drawn KJM Date 20/09/2017 Checked P.A. Approved M.S. COPYRIGHT ©	In Association With BUSHLAND GROVE PTY LTD BUSHLAND GROVE ESTATE STAGE 13, 26 ALLOTMENT RESIDENTIAL SUBDIVISION, MOUNT LOW	BUILDING ENVELOPE & ACCESS PLAN
Drawing Number TUR0813/E2		Issue A